

INFORMATION REPORT INFORMATION REPORT**CENTRAL INTELLIGENCE AGENCY**

This material contains information affecting the National Defense of the United States within the meaning of the Espionage Laws, Title 18, U.S.C. Secs. 793 and 794, the transmission or revelation of which in any manner to an unauthorized person is prohibited by law.

C-O-N-F-I-D-E-N-T-I-A-L

25X1

COUNTRY **Albania**
SUBJECT **Road Data/Bridges**

REPORT DATE DISTR. *29 Aug 1960*NO. PAGES **1**

25X1

DATE OF
INFO.
PLACE &
DATE ACQ.

25X1

THIS IS UNEVALUATED INFORMATION

25X1

2. The road is approximately two lanes wide and is constructed for heavy usage. The roadbed is constructed of crushed stone and the top layer is gravel surfaced with sand. However near a large city or town the top layer of the road is asphalt surfaced.

3. The loose surface, all weather road from Fegades to Shkoder is considered to be a first class highway in Albania. In some sections the roadbed has a natural rocky and stony foundation because the road runs through mountainous terrain.

25X1

The road is in poor condition and any maintenance which is required is performed by villagers and farmers.

25X1

between Elbasan and Shkoder via Tirane and Les not any military installations or any factories.

25X1

4. between Tirane and Shkoder two concrete constructed bridges.

25X1

the bridges were barely two lanes wide. One bridge is located at Milot which crosses the Mat River. The river flows down from the mountains in a southeasterly direction into the Adriatic Sea. The second bridge is located at Les which crosses the Drin River which also flows down from the mountains southeasterly into the Adriatic Sea. Both bridges are able to absorb heavy usage but are in poor condition.

25X1

5
4
3
2
15
4
3
2
1

-end-


-end-

STATE	ARMY	NAVY	AIR	FBI	AEC				
-------	------	------	-----	-----	-----	--	--	--	--


C-O-N-F-I-D-E-N-T-I-A-L**INFORMATION REPORT INFORMATION REPORT****NOFORN****NO DISSEM ABROAD****LIMITED**

LIMITED: Dissemination limited to full-time employees of CIA, AEC and FBI; and, within State and Defense, to the intelligence components, other offices producing NIS elements, and higher echelons with their immediate supporting staffs. Not to be disseminated to consultants, external projects or reserve personnel on s

Approved For Release 2009/08/06 : CIA-RDP80T00246A011200190001-6

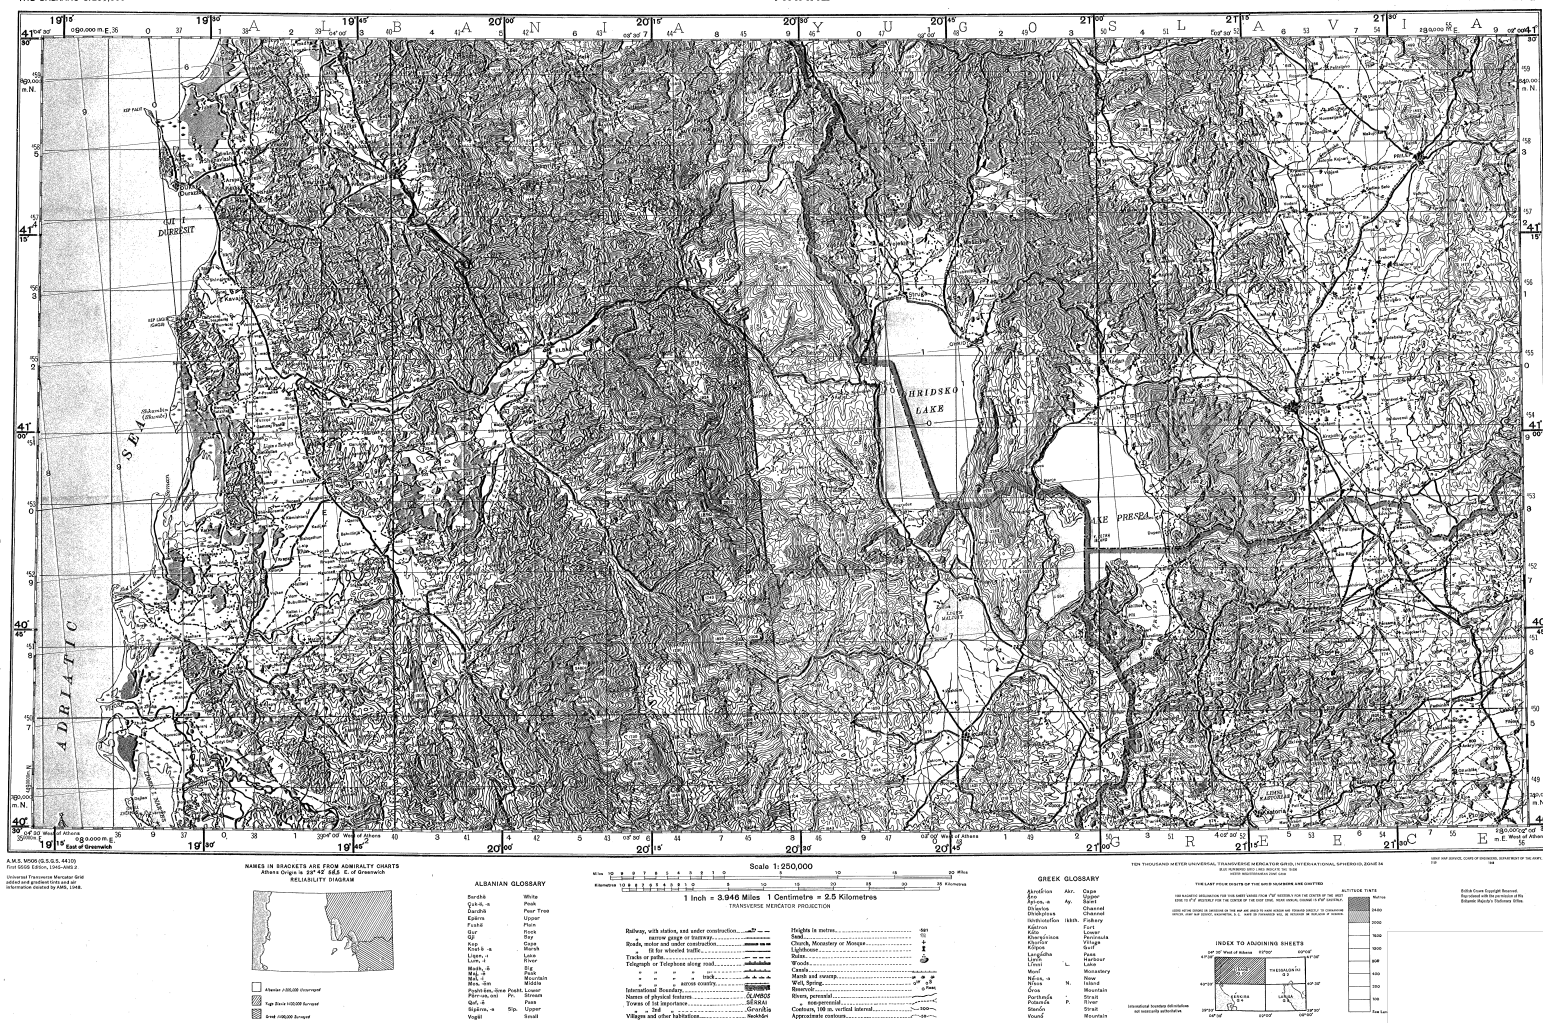

THE BALKANS 1:250,000

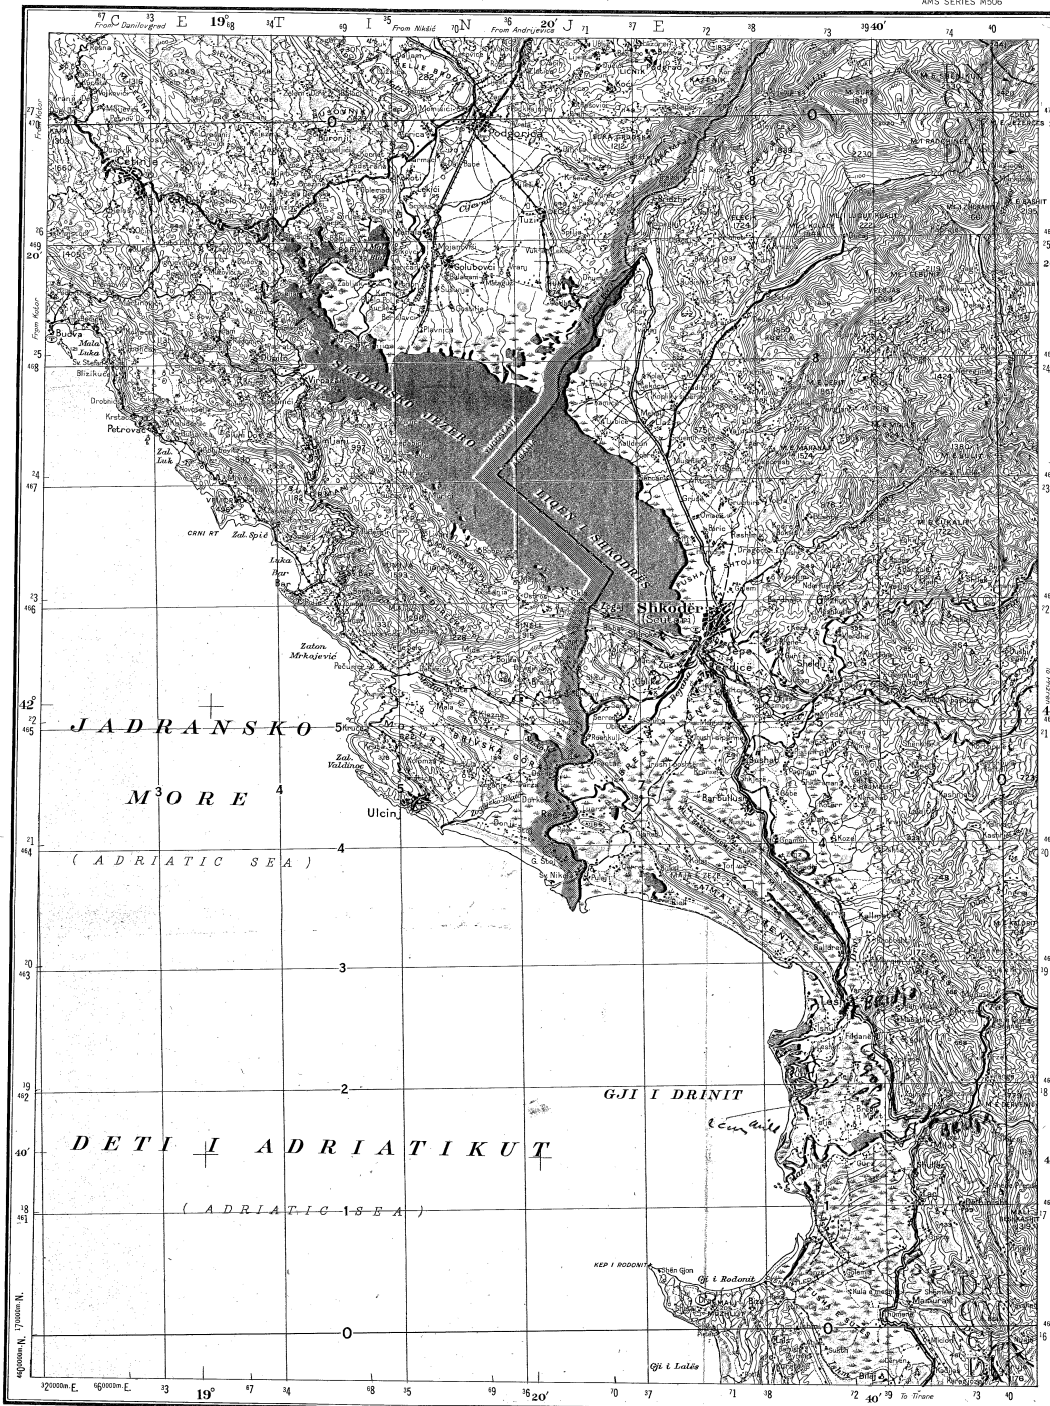

GLOSSARY OF SERBO-CROAT TOPOGRAPHICAL TERMS

[illegible]

KEY TO SERBO-CROAT PRONUNCIATION

	KEY TO SERBO-CROAT TRANSCRIPTION
a	short "ah" almost as u in butt
as	as in <i>hate</i>
č, č	as ch in <i>church</i>
d, đ	as dge in <i>edge</i>
e	as e in <i>bed</i>
g	as g in <i>gale</i>
h	as Scots gh in <i>loch</i>
i	as i in <i>machine</i>
j	as y in <i>yes</i>
č	as sh in <i>recession</i>
lj	as ny in <i>caravan</i>
o	as o in <i>got</i>
r	often used as so
š	rolled as Scots r
s	as sh in <i>shall</i>
u	as oo in <i>brood</i>
t	as s in <i>pleasure</i>

GLOSSARY OF ALBANIAN TOPOGRAPHICAL TERMS


Prepared by the Army Map Service (AM), Corps of Engineers, U. S. Army, Washington, D. C. Copied in 1953 from The Balkans, 1:250,000, GSGS, Sheet Y-46, 1943. Major communications revised from intelligence data to 1952, Universal Transverse Mercator Grid and bilingual marginal data added.

THORITIES

AUTHORITIES	
Yugoslavia 1:000,000. Vojni Geografski Institut, Kraljevine Jugoslavije. Sheets 127-128 (1941).	BASIC R
Karte Autonomnih Puteva, Kraljevine Jugoslavije 1:600,000 (1940).	
Karte Kraljevine Jugoslavije. Vojnogigrafski Institut, Beograd 1:500,000 (1940).	GENERAL R
Albania 1:200,000 North Sheet G. S. B. 6-8/8 (1928) Corrected from Intelligence Reports up to 1943.	ROADS
Red Condition Map of 1:1,000,000. Intelligence Towing Ltd., Beograd, corrected from Intelligence Reports up to Jan. 1943.	
Railways of Yugoslavia 1:1,000,000 Corrected from Intelligence Reports up to Jan. 1943.	RAILWAYS

British Crown Copyright Reserved.
Reproduced with the permission of Her
Britannic Majesty's Stationary Office.

THE DELINEATION OF INTERNATIONAL BOUNDARIES ON THIS MAP MUST
NOT BE CONSIDERED AUTHORITATIVE

GRIDS AND GEOGRAPHIC VALUES ON THIS SHEET ARE APPROXIMATE
LES QUADRILLAGES ET LES CARROYAGES QUI SONT FIGURÉS SUR CETTE
FEUILLE SONT APPROXIMATIFS

INDEX TO ADJOINING SHEETS

COMPILATION DIAGRAM



Yugoslavia 1:100,000 Survey

PRINTED BY ARMY MAP SERVICE, CORPS OF ENGINEERS, 1-54, 17395

AMS M506 (GSGS 4413)
Edition 2-AMS

LEGEND

[illegible]

Scale: 1:250,000

TRANSVERSE MERCATOR PROJECTION

BLACK NUMBERED LINES INDICATE THE 10,000 METER UNIVERSAL TRANSVERSE
MERCATOR GRID, ZONE 34, INTERNATIONAL SPHEROID

LES LIGNES CHIFFRÉES EN NOIR CORRESPONDENT AU QUADRILLAGE

RED NUMBERED TICKS INSIDE THE NEUTLON INDICATE THE 10,000 METER
DANUVE ZONE (GIRD, BESSSEL, SPHEROID)

LES AMORCES MYRIAMÉTRIQUE CHIFFRÉES EN ROUGE À L'INTÉRIEUR
DE CADRE CORRESPONDENT AU QUADRILLAGE DANUVE, ELLIPSOÏDE DE BESSSEL

THE LAST FOUR DIGITS OF THE GRID NUMBERS ARE OMITTED
LES QUATRE DERNIERS CHIFFRES DES NUMÉROS DE QUADRILLAGE SONT OMIS

HEIGHTS IN METERS

NOTING ERRORS OR OMISSIONS ON THIS MAP ARE LIMITED TO HOME VERSION AND FORWARDED DIRECTLY TO COMNAV
R. ARMY MAP SERVICE, WASHINGTON, D. C. MAPS SO FORWARDED WILL BE RETURNED OR REPLACED IF OF

SHKODËR (SCUTARI). ALBANIA; YUGOSLAVIA